EASEMENT SURVEY FOR RELOCATION OF FOREST ROAD NO. 329

THROUGH SE1/4 SE1/4 SECTION 2, T.15S., R.11E., N.M.P.M.

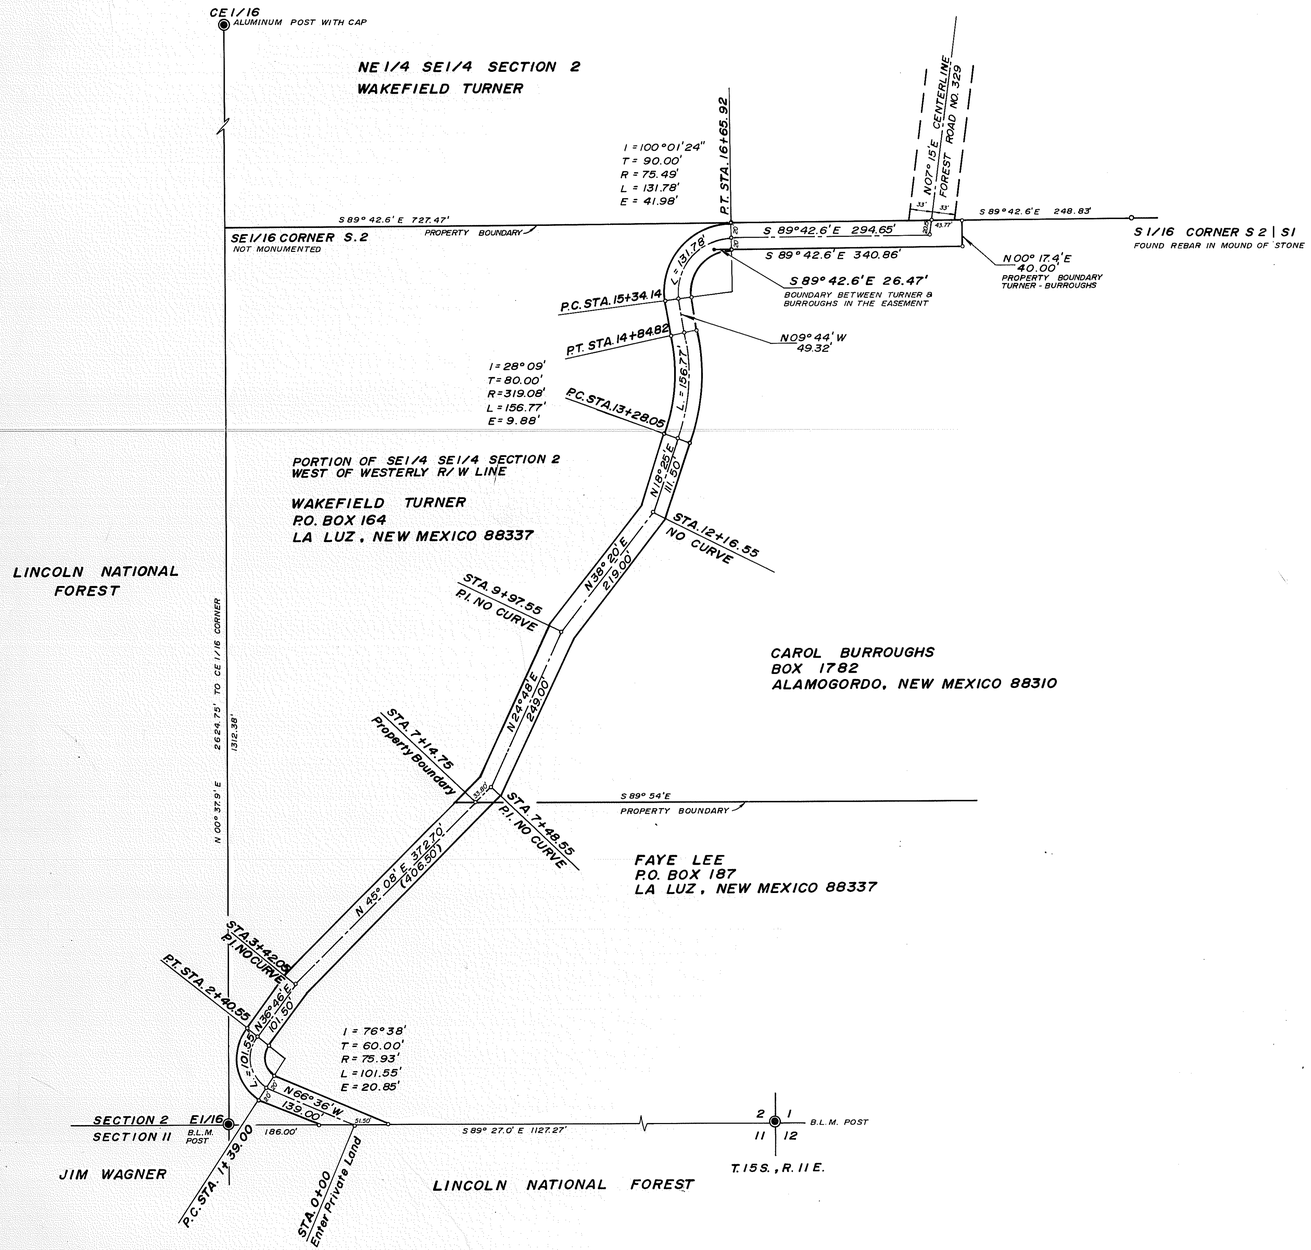

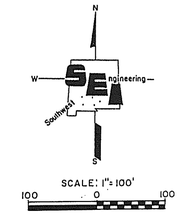

CERTIFICATION

THIS PLAT REPRESENTS A RECORD OF THE SURVEY OF AN EASEMENT FOR RELOCATED FOREST ROAD No. 329 THROUGH THE SOUTHEAST QUARTER OF THE SOUTHEAST QUARTER OF SECTION 2, T15S., R11E., N.M.P.M., OTERO COUNTY, NEW MEXICO.

THE EASEMENT FOLLOWS THE CENTERLINE OF THE ROADWAY AS CONSTRUCTED BY OTERO COUNTY AT THE REQUEST OF THE LANDOWNERS. PRIVATE PROPERTY BOUNDARIES BETWEEN LEE, BURROUGHS AND TURNER SHOWN ON THIS PLAT ARE BASED ON THE BEST AVAILABLE EVIDENCE REMAINING FROM A PRIVATE SURVEY THAT WAS MADE PRIOR TO THE RE-ESTABLISHMENT OF THE SECTION LINES BY BLM IN 1967.

I CERTIFY THAT THIS SURVEY AND RECORD THEREOF WAS MADE BY ME OR MY ASSISTANTS UNDER MY SUPERVISORY DIRECTION IN APRIL 1989 AND THAT THE SAME IS TRUE AND CORRECT TO THE BEST OF MY KNOWLEDGE.

Wilfried E. Roeder 6/12/89
WILFRIED E. ROEDER
REGISTERED PROFESSIONAL LAND SURVEYOR
NEW MEXICO REGISTRATION No. 4691
LINCOLN NATIONAL FOREST, ALAMOGORDO, NEW MEXICO

REGISTERED LAND SURVEYOR STATE OF NEW MEXICO NO. 4691 WILFRIED E. ROEDER

APPROVED: Jose M. Martinez 6/12/89
JOSE M. MARTINEZ
FOREST ENGINEER
LINCOLN NATIONAL FOREST, ALAMOGORDO, NEW MEXICO

STATE OF NEW MEXICO } S.S.
OTERO COUNTY
FILED FOR RECORD IN MY OFFICE
This 28 day of June 19 89
At 11:00 o'clock A M and duly recorded
in Book 39 Page 39 Plat 56-57
the records of Otero County, New Mexico
Donna J. Quiver
County Clerk, Otero County, New Mexico
By Robyn M. Silva Deputy
#5344

LINCOLN NATIONAL FOREST

MAY 1, 1989 JOB NO. A-89-56

SOUTHWEST ENGINEERING INC.
475 ARCHULETA RD., LAS CRUCES, NEW MEXICO 88005 - (505)526-3381
1000 ZUNI DR., ALAMOGORDO, NEW MEXICO 88310-(505)437-1501

THIS PLAT WAS PREPARED BY SOUTHWEST ENGINEERING, INC. FROM INFORMATION PROVIDED BY LINCOLN NATIONAL FOREST, USDA.

S2 T15 R11-FOREST RD
BK 39 PG 56 - 57