EASI FILE CORP IRVINE CA EFH 24

TIMBERON #4 BLK 49 LOT 53

BK 50 PG 66

CERTIFICATE OF SURVEY
LOT 53, BLOCK 49, TIMBERON SUBDIVISION, UNIT-4, OTERO COUNTY, NEW MEXICO

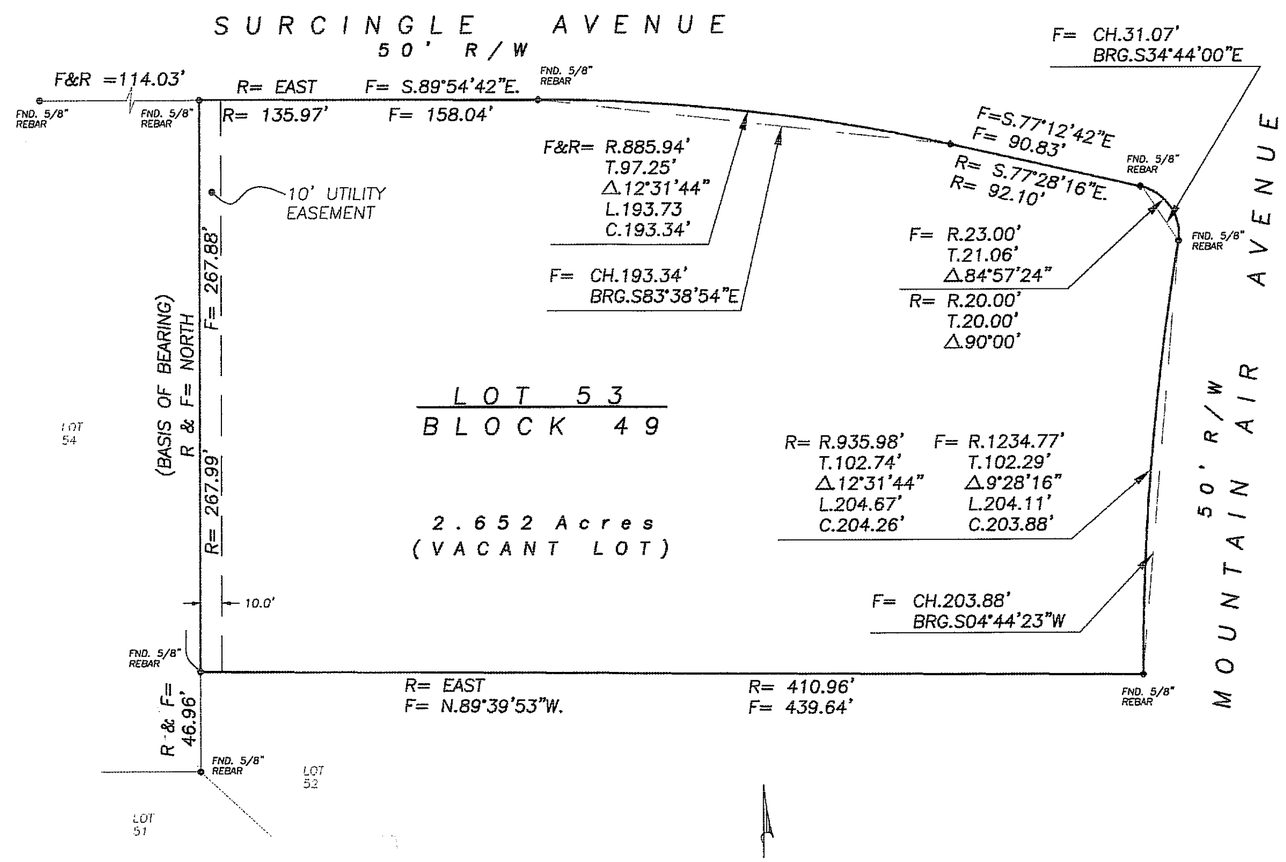

N

SCALE: 1"=50'

10 0 50 100

R= RECORD DATA
F= FIELD MEASUREMENT
R.= RADIUS
T.= TANGENT
L.= LENGTH
C.= CHORD
Δ = DELTA

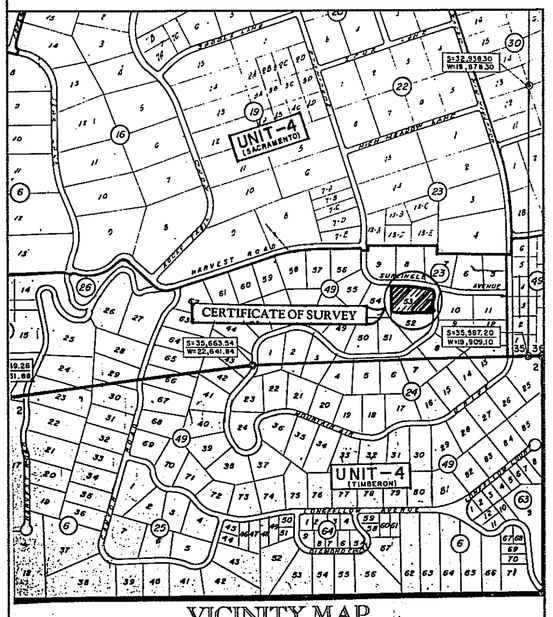

VICINITY MAP
NO SCALE

DEDICATION

STATE OF NEW MEXICO)
COUNTY OF OTERO)

KNOW ALL MEN BY THESE PRESENTS THAT **DOLORES ~~SWISFORD~~ SWEISFORD** IS THE OWNER AND PROPRIETOR OF LOTS 53, BLOCK 49, TIMBERON SUBDIVISION, UNIT-4, OTERO COUNTY, NEW MEXICO, AS FILED FOR RECORD IN THE OFFICE OF THE OTERO COUNTY CLERK AND EX-OFFICIO RECORDER ON THE 19th DAY OF OCTOBER, 1971. SAID OWNER HAS CAUSED SAID LOT TO BE SURVEYED AND MONUMENTED AS SHOWN ON THIS PLAT, AND DOES HEREBY ACCEPT AND APPROVE THIS SURVEY. IN WITNESS THEREOF SAID OWNER HAS SET HER HAND AND SEAL ON THIS 14th DAY OF August, 1997.

Dolores Sweisford
DOLORES ~~SWISFORD,~~ SWEISFORD OWNER

ACKNOWLEDGMENT

STATE OF ~~NEW MEXICO~~ Texas)
COUNTY OF ~~OTERO~~ El Paso)

THE FOREGOING INSTRUMENT WAS ACKNOWLEDGED BEFORE ME THIS 14th DAY OF August, 1997 BY **DOLORES ~~SWISFORD,~~ SWEISFORD**

Alicia M Upchelbe, NOTARY PUBLIC. MY COMMISSION EXPIRES: 04-09-2001.

CERTIFICATE

I, GEORGE P. LIGHT, HEREBY CERTIFY THAT THIS PLAT WAS PREPARED FROM AN ACTUAL SURVEY MADE UNDER MY SUPERVISION AND THAT THIS SURVEY AND PLAT MEETS THE MINIMUM STANDARDS FOR SURVEYING IN NEW MEXICO AND THAT THE SAME IS TRUE AND CORRECT TO THE BEST OF MY KNOWLEDGE AND BELIEF.

George P. Light
GEORGE P. LIGHT, P. S. No. 4621

GEORGE P. LIGHT NEW MEXICO 4621 7-25-97 REGISTERED LAND SURVEYOR

RECORDING

RECORDED IN THE OFFICE OF THE COUNTY CLERK AND EX-OFFICIO RECORDER OF OTERO COUNTY, NEW MEXICO, AT 4:20 O'CLOCK, P. M., THIS 22nd DAY OF August, 1997.

Mary D. Quinton COUNTY CLERK. BY: Robyn Silva, DEPUTY.

RECEPTION No. 8116 BOOK: 50, PAGE: 66.

MOUNTAIN SURVEYS
P.O. Box 853 Cloudcroft, New Mexico 88317 Tel. (505) 682-2537 Fax (505) 682-6008

Job No.: 040-97 Date: July 1997 Client: Swisford
Description: Lot 53, Block 49, Timberon Subdivision Unit -4
Otero County, New Mexico. Plat Filed October 19, 1971.