SEC11, T17S, R12E

BK 57 PG 39

RETRACEMENT SURVEY, SUBDIVISION AND MONUMENTATION OF SECTION 11 A PORTION OF THE LINCOLN NATIONAL FOREST PROPERTY.

SITUATED IN TOWNSHIP 17 SOUTH, RANGE 12 EAST, OF THE NEW MEXICO PRINCIPAL MERIDIAN.

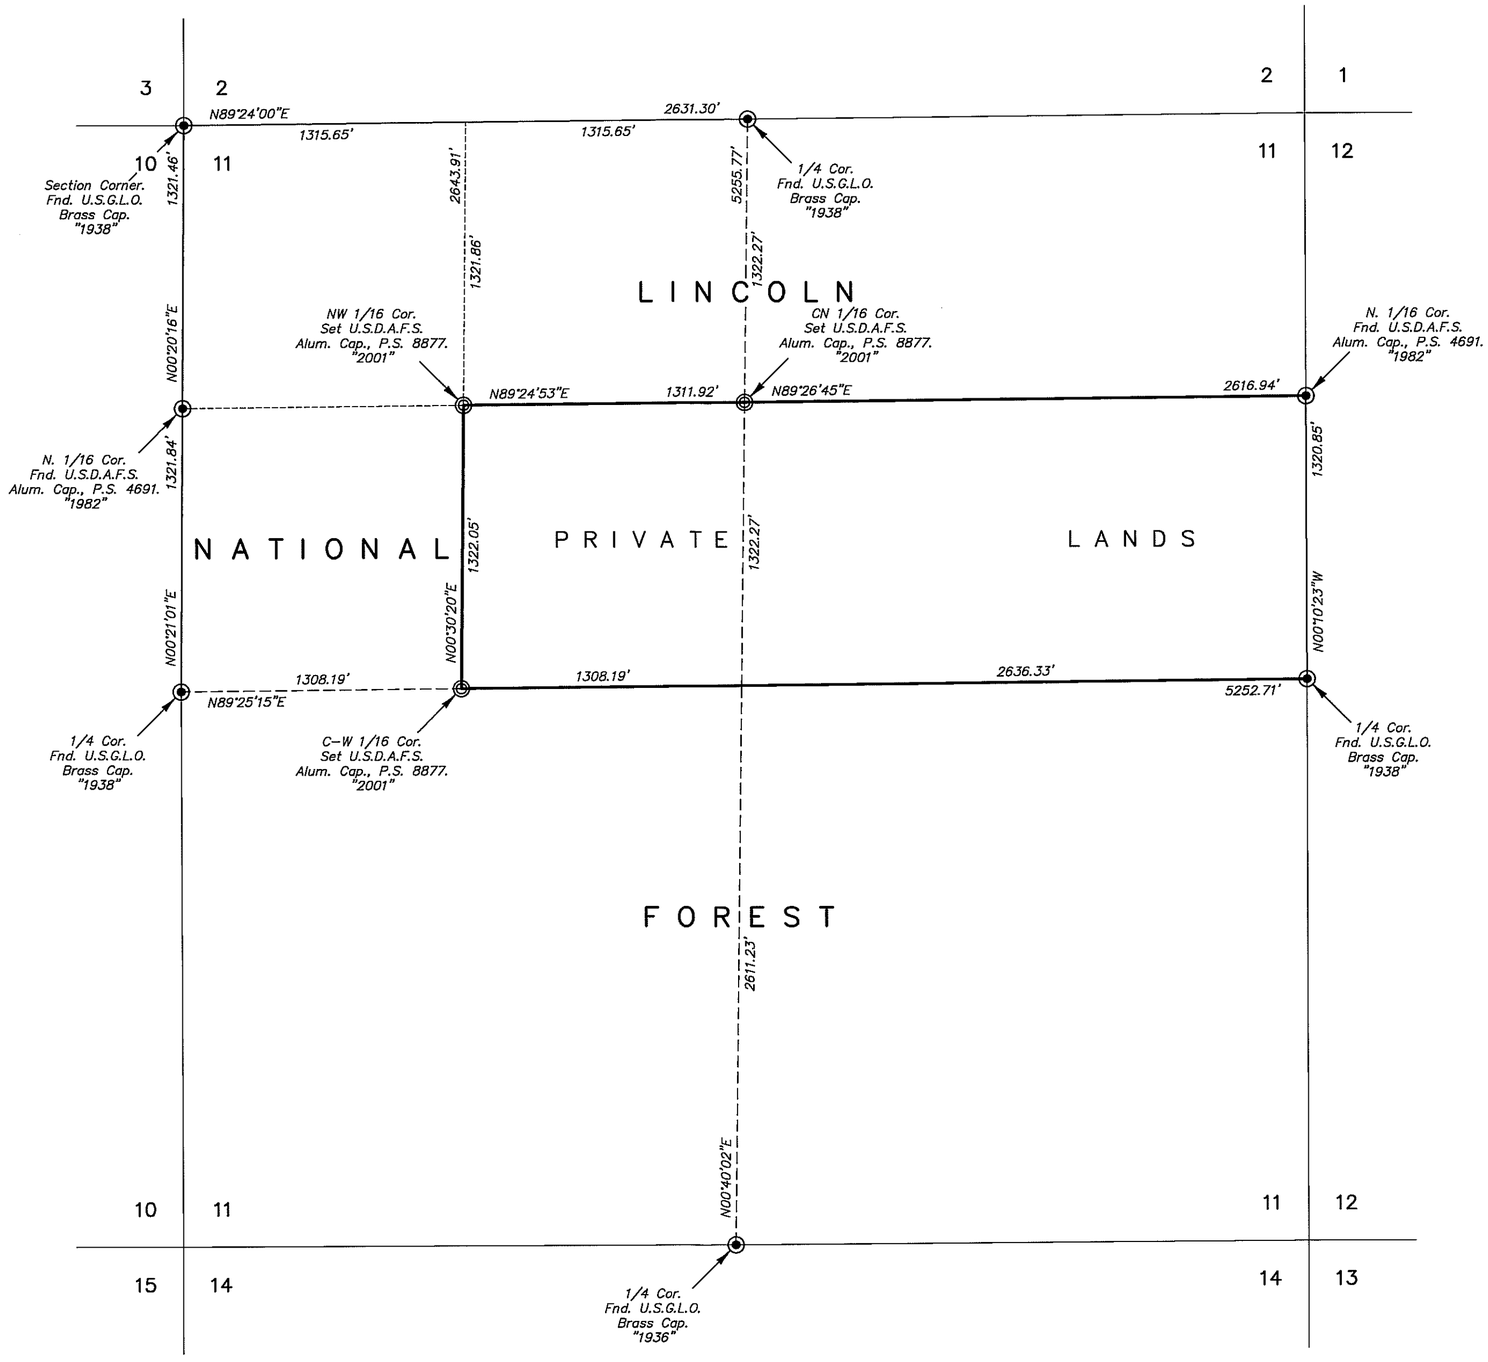

GRAPHIC SCALE

500' 0' 500' 1000'

Scale 1" = 500'

NOTE:

◎ SET UNITED STATES DEPARTMENT OF AGRICULTURE FOREST SERVICE ALUMINUM CAP BY THIS SURVEY. CAP ATTACHED TO A 2.5 INCH BY 30 INCH ALUMINUM POST.

CERTIFICATION:

THIS PLAT REPRESENTS A RECORD OF THE SURVEY, SUBDIVISION AND MONUMENTATION OF SECTION 11, T. 17 S., R. 12 E., N.M.P.M., OTERO COUNTY, NEW MEXICO WHICH CONSTITUTES A PORTION OF THE LINCOLN NATIONAL FOREST.

THE ORIGINAL SURVEY OF T. 17 S., R. 12 E., WAS EXECUTED BY BART A. NYMEYERS, U.S. DEPUTY SURVEYOR IN 1896. A RESURVEY OF THE TOWNSHIP WAS MADE BY WENDELL G. HALL, SURVEYOR, IN 1938, IS A RECORD OF THE BLM IN SANTA FE, NEW MEXICO. THE EVIDENCE OF THE OFFICIAL CORNER MONUMENTS FOUND IS DESCRIBED IN THE FIELD NOTES AND MADE PART OF THE RECORD.

THE BEARINGS ON THIS PLAT ARE BASED ON THE 1938 RECORD BEARING FOR THE NORTH HALF MILE BETWEEN SECTIONS 10 AND 11. ALL DISTANCES ARE MEASURED ELECTRONICALLY.

THIS SURVEY, SUBDIVISION, MONUMENTATION AND RECORD THEREOF WAS MADE AS A RESULT OF THE SUPERVISOR OF LINCOLN NATIONAL FOREST, AND IS FOR THE PURPOSE OF IDENTIFYING AND PERPETUATING THE EVIDENCE OF THE ORIGINAL SURVEY, AND IS INTENDED FOR HIS EXCLUSIVE USE.

I CERTIFY THAT THIS SURVEY, SUBDIVISION, MONUMENTATION AND RECORD THEREOF WAS MADE BY ME OR MY ASSISTANTS UNDER MY DIRECTION IN JULY 2001, THAT IT MEETS THE MINIMUM REQUIREMENTS OF THE STANDARDS FOR LAND SURVEYING IN NEW MEXICO, AS ADOPTED BY THE NEW MEXICO STATE BOARD OF REGISTRATION FOR PROFESSIONAL ENGINEERS AND LAND SURVEYORS AND THAT THE INFORMATION SHOWN HEREON IS TRUE AND CORRECT TO THE BEST OF MY KNOWLEDGE.

ECTOR G. ALVARADO No. 8877 NEW MEXICO REGISTERED PROFESSIONAL SURVEYOR

Ector G. Alvarado Oct. 4, 2001.

ECTOR G. ALVARADO, P.S. NO. 8877 DATE

FILED FOR RECORD IN THE OFFICE OF THE COUNTY CLERK OF OTERO COUNTY, NEW MEXICO, ON THE 19th DAY OF October, 2001, IN ~~CABINET~~ BOOK 57, ~~SLIDE~~ PAGE 39.

ATTEST: Robyn Silva DEPUTY

Mary D. Quintana COUNTY CLERK

RECEIPT NUMBER: 10571 FEE: 8.00 TIME: 2:45 pm

JOB NO. C1-794	DATE: 07-09-01	DRAWN BY: E.G.A.	Indexing Information for County Clerk				
			Owner(s)	Section(s)	Township(s)	Range(s)	Subdivision
PLAT NO. 295	SCALE 1" = 500'	CHECKED BY: J.A.R.	LINCOLN NATIONAL FOREST	11	17	12	N/A

EAGLE LAND SURVEYING

P.O. BOX 2342 RUIDOSO, NEW MEXICO 88355 PH. (505)257-2275